


Pls. check
w/it CRD.

SECTION ①
1:15

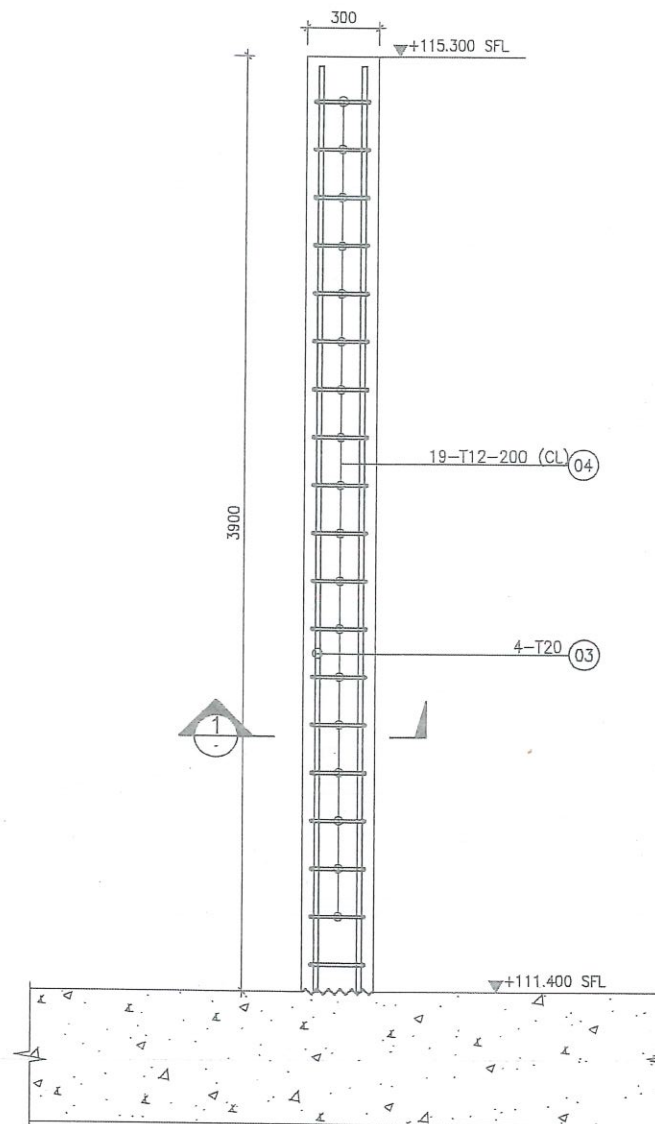

Not.

Accept ER's Comment (s)
See Comments in Review Sheet
Design/AR/E&M/Engg. Mgr.

15/3/2021

Drawing is Correct Already

Refer CRD Drawing No. 2-OR19-SE-6501-01

Rev. H

GOOD FOR CONSTRUCTION

Certified by CKST Date: 04 FEB 2021

Endorsed by Designer AGATE

Date: 09 FEB 2021

DETAIL ①
1:15

C7
(12 SETS)

PMSC2 WORKING DRAWING REVIEW			
1 = NONE	SIGN :	/M	
2 = NONE W/COMMENT	NAME :	Siwakorn S.	
3 = SUC	POSITION :	US	
4 = REJECTED	DATE :	04 MAR 2021	



SCALE :
A1 = 1:15
A3 = 1:30
UNITS :
mm.

ORANGE LINE PROJECT			
CONTRACT E2 : UNDERGROUND CIVIL WORKS			
OR19 : HUA MAK STATION ENTRANCE 1			
GENERAL ARRANGEMENT PLAN - INTERNAL STRUCTURE			
UPPER ROOF LEVEL ELEV.+111.100 TO ELEV.+115.000 SFL (SHEET 3/4)			
STATUS :	DRAWING NO.	REVISION :	SHEET NO.
W	2-OR19-SE-6101-62	A	-

URP Steel Reinforcement Specialist
(Thailand) Co., Ltd.

KINGDOM OF THAILAND
MINISTRY OF TRANSPORT
MASS RAPID TRANSIT AUTHORITY OF THAILAND

EMPLOYER'S REPRESENTATIVES:

IPMCSC2 **AEC** **WE** **QUM**

PROJECT MANAGEMENT AND SUPERVISION CONSULTANT & SPECIALIST
FOR THE CHANGING AND IMPROVING PROJECT
THAILAND RAILWAY CO., LTD. - THE RAILWAY AUTHORITY OF THAILAND

CONTRACTOR : CKST JOINT VENTURE			
DESIGNER	KB		
DESIGN CHECKED	PC		
PROJECT MANAGER	PP		
REV.	DATE	REVISIONS	DIAG. CHK. APP.
A	18-12-20	FIRST ISSUED	


DESIGN : AGATE CONSORTIUM

AECOM **GFE**

TEAM Consulting Engineering and Management Co., Ltd.



Not
Accept ER's Comment (s)
See Comments in Review Sheet
15/3/2021
Design/AR/E&M/Engg. Mgr.

Drawing is Correct Already
Refer CRD Drawing NO. 2-OR19-SE-6501-01
Rev. 4

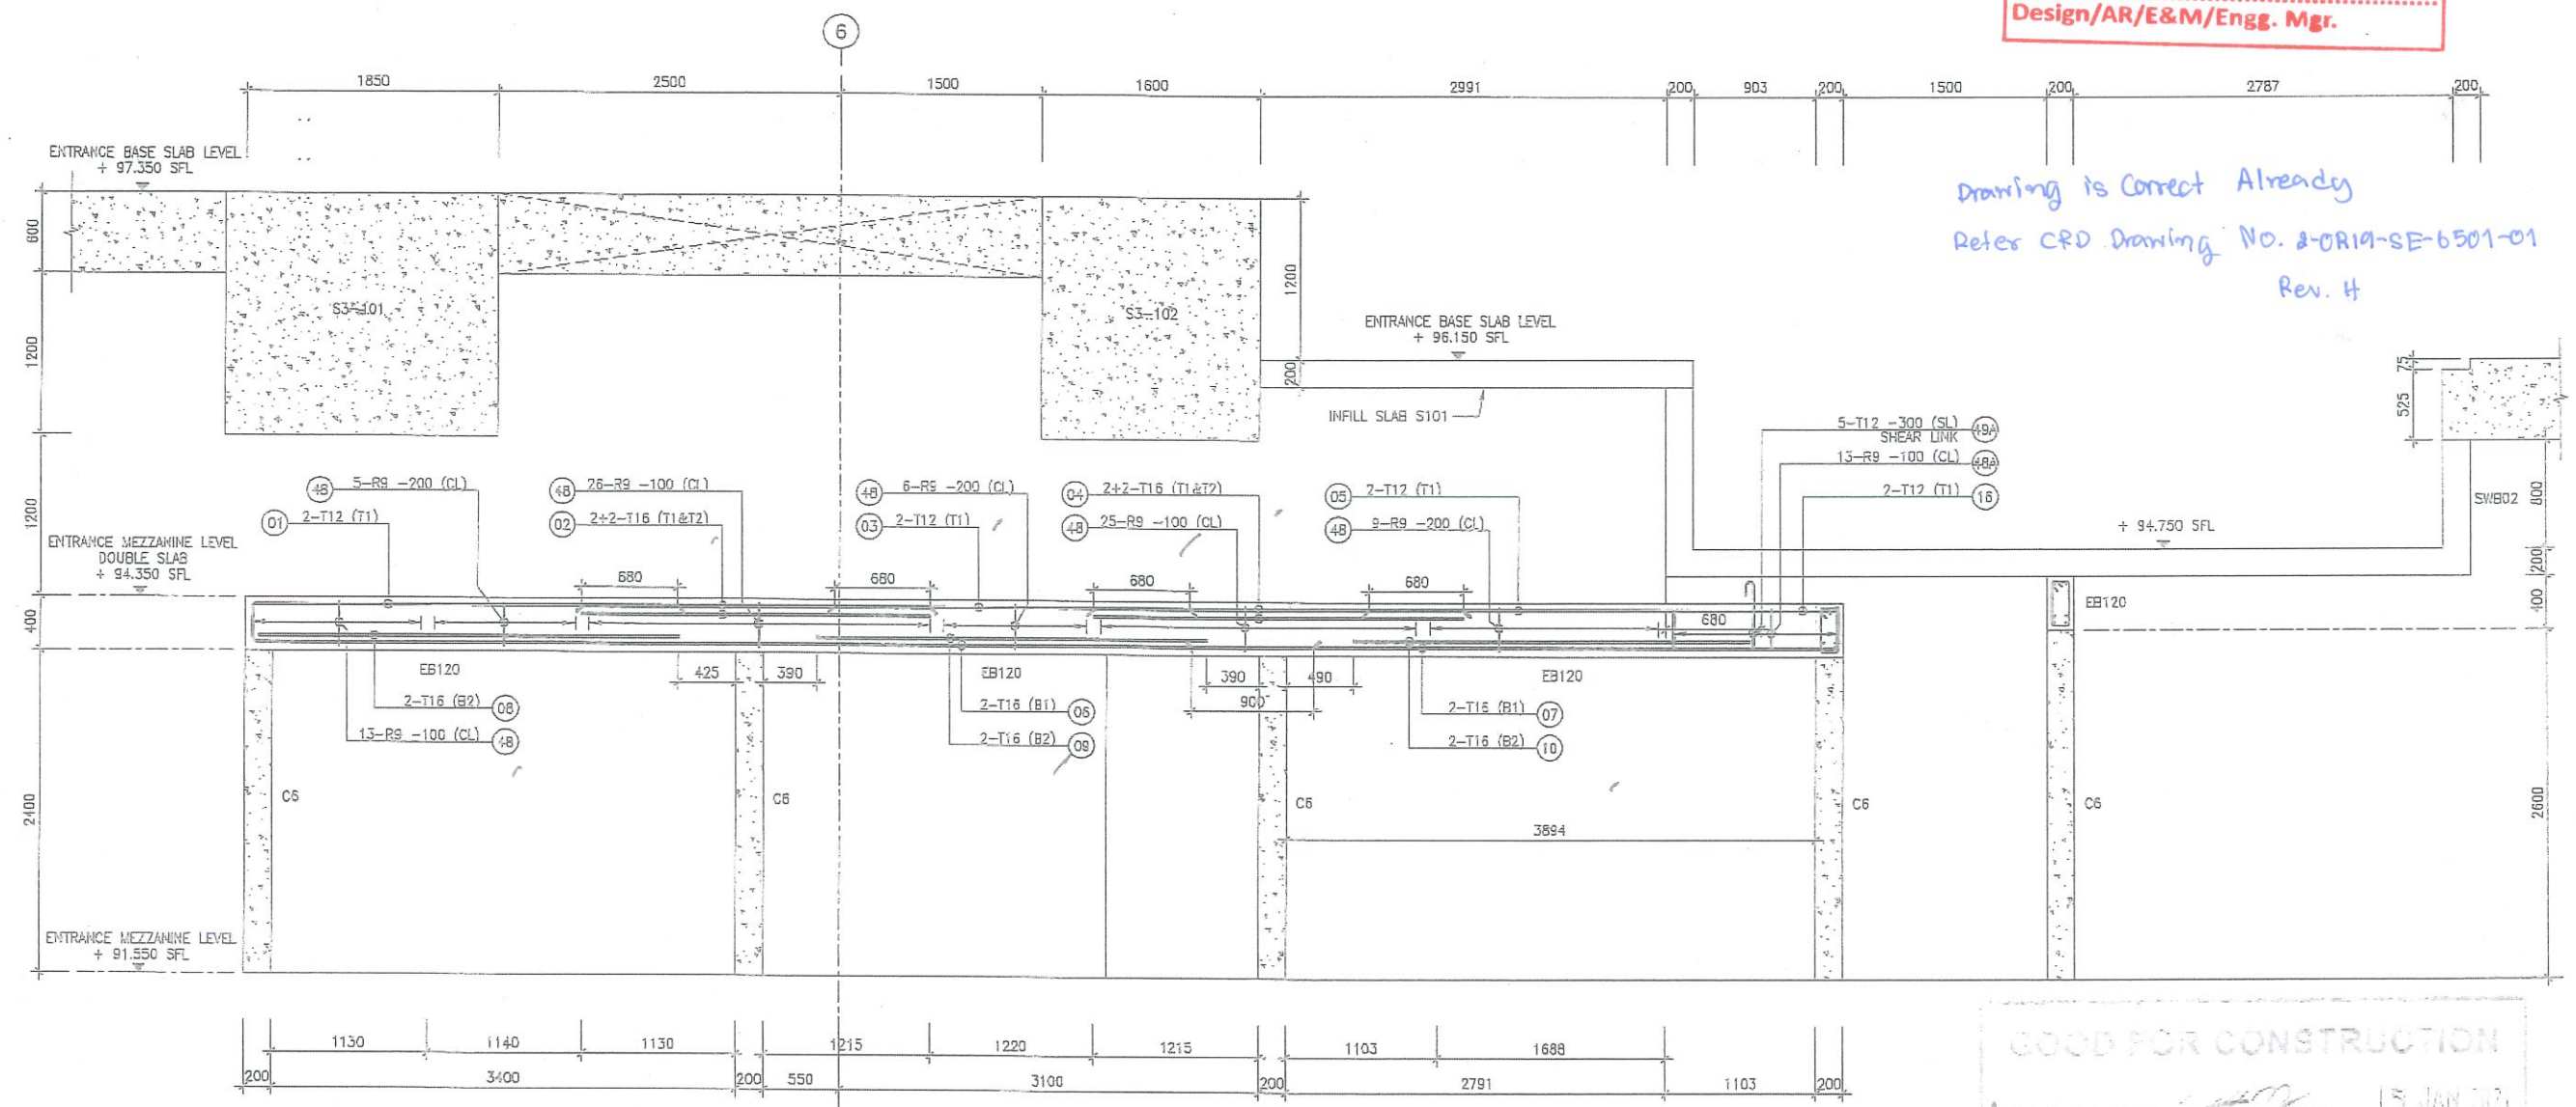

GOOD FOR CONSTRUCTION

Checked by: [Signature] Date: 13 JAN 2021
Endorsed by Designer/AGATE: [Signature] Date: 18 JAN 2021

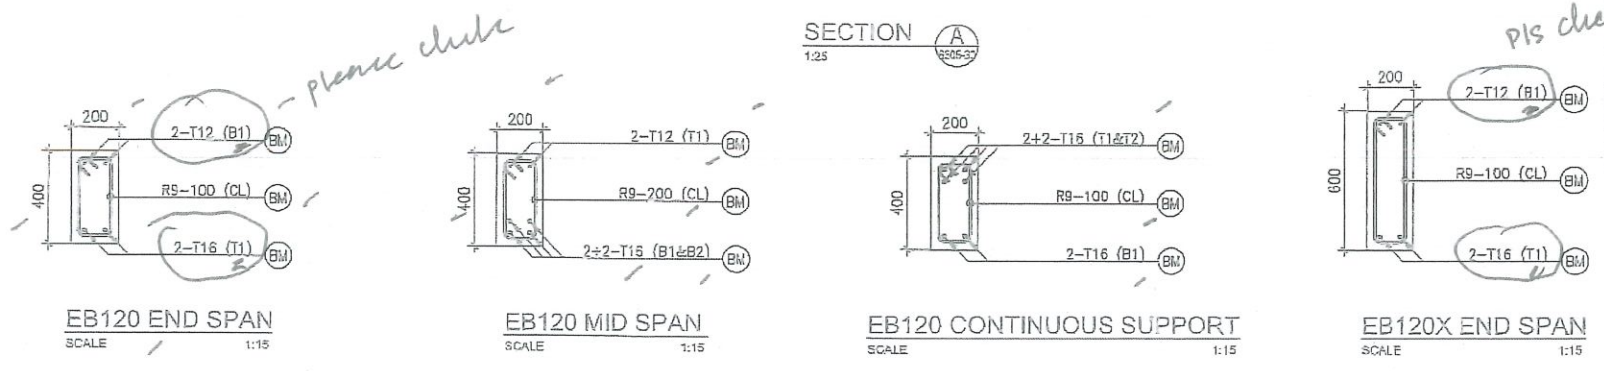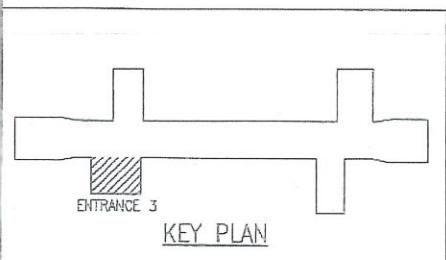

Steel Reinforcement Specialist
(Thailand) Co., Ltd.

KINGDOM OF THAILAND
MINISTRY OF TRANSPORT
MASS RAPID TRANSIT AUTHORITY OF THAILAND

EMPLOYERS REPRESENTATIVES:
PMCS2
AEC
WE
GFE

CONTRACTOR: CH2M HILL
DESIGN: AGATE CONSULTING
PROJECT MANAGER: [Signature]
DESIGNER: [Signature]
CHECKED: [Signature]
DATE: 25-09-2020




PMCS2 WORKING DRAWING REVIEW			
1 = HONO	SIGN :	NAME :	POSITION :
2 = HONO W/COMMENT			
3 = SDO			
4 = REJECTED			


ORANGE LINE PROJECT
CONTRACT E2 : UNDERGROUND CIVIL WORKS
OR19: HUA MAK STATION ENTRANCE 3
INTERNAL STRUCTURES - R.C. SLAB AND BEAM
MEZZANINE LEVEL DOUBLE SLAB ELEV. +94.350 SFL (SHEET 3/9)

SCALE: A1 = 1:25
A3 = 1:50
UNITS: m.m.
DATE: 25-09-2020


STATUS: W
DRAWING NO. 2-OR19-SE-6505-32
REVISION: A
SHEET NO. -

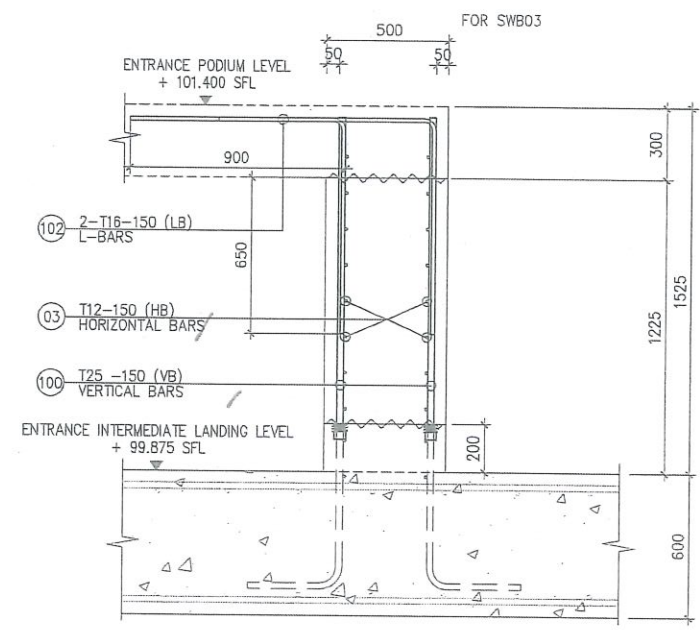




DETAIL A
1:15
6402-30

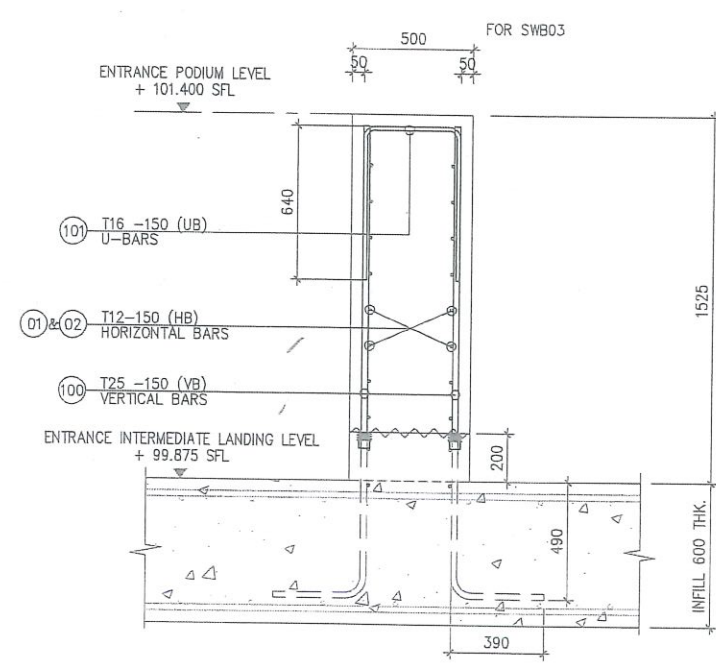


DETAIL B
1:15
6402-30

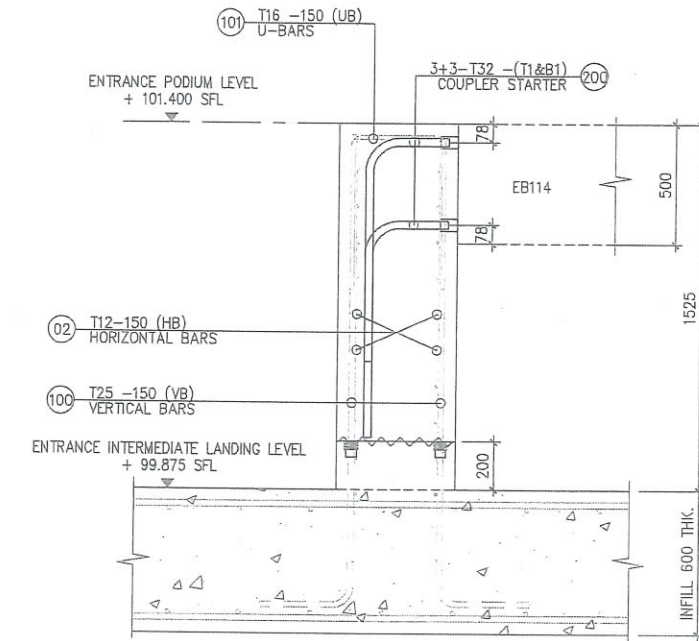

BEAM EB114 DETAIL
SCALE 1:15

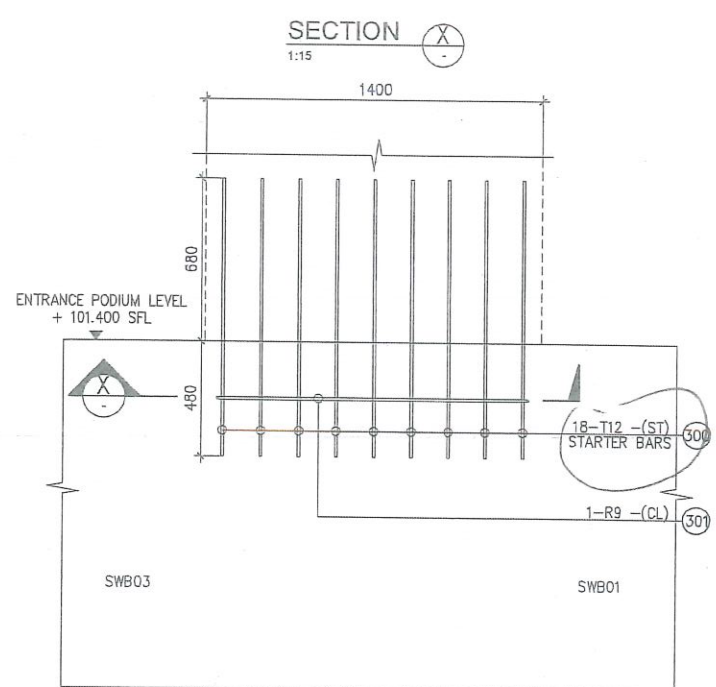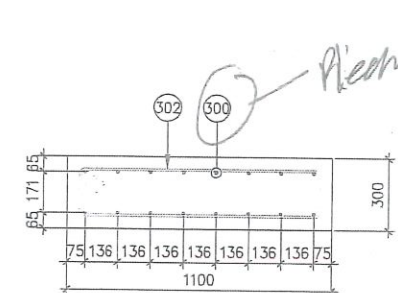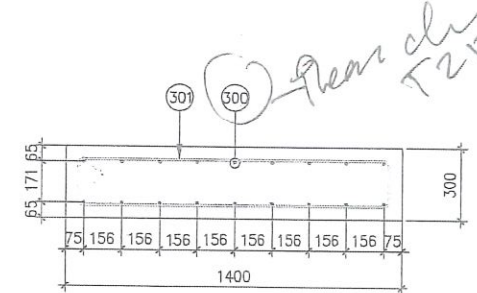

COLUMN C1 DETAIL
SCALE 1:15

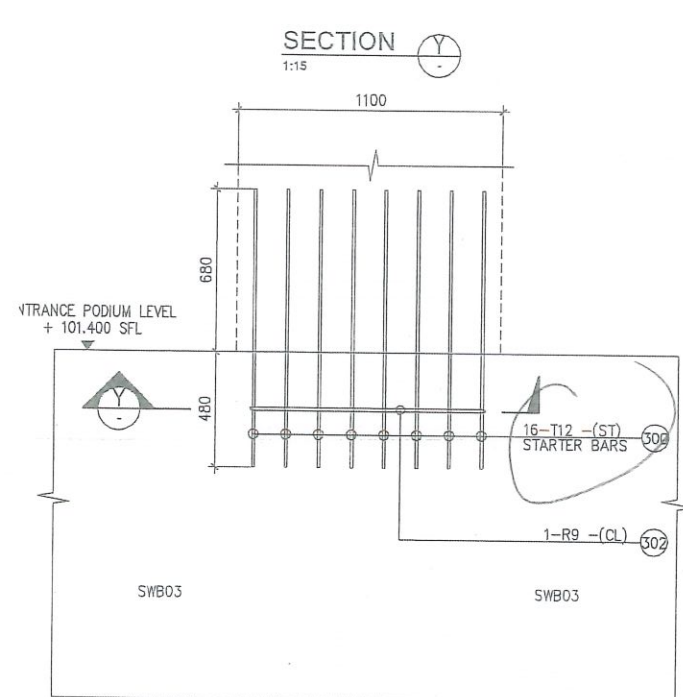

COLUMN C5 DETAIL
SCALE 1:15

Not Accept ER's Comment (s)
See Comments in Review Sheet
Design/AR/E&M/Engg. Mgr.

Drawing is Correct Already
Refer CRD Drawing No. 2-OR19-SE-6501-01
Rev. H.

GOOD FOR CONSTRUCTION

Certified by CKST Date: 27 AUG 2020

Endorsed by Designer AGATE Date: 27 AUG 2020

PMSC2 WORKING DRAWING REVIEW			
1 = NONE	SIGN :	NAME :	DATE :
2 = NONE W/COMMENT			
3 = SCO			
4 = REJECTED			



ORANGE LINE PROJECT			
CONTRACT E2 : UNDERGROUND CIVIL WORKS			
OR19 : HUA MAK STATION ENTRANCE 4			
GENERAL ARRANGEMENT PLAN - INTERNAL STRUCTURE			
REINFORCEMENT FOR WALL, BEAM & COLUMN (SHEET 2/3)			
STATUS :	DRAWING NO.	REVISION :	SHEET NO.
W	2-OR19-SE-6402-31	A	-

SCALE :	A1 = 1:15
	A3 = 1:30
UNITS :	mm.
DATE :	01-07-2020

DESIGNER	CHK	DATE	REVISIONS	DWG.	CHK.	APP.
PC	PC	01-07-20	FIRST ISSUED			
PP	PP					

EMPLOYER'S REPRESENTATIVES:		CONTRACTOR : CKST JOINT VENTURE	
PMSC2	AEC	STECON	AGATE CONSORTIUM
WE CONSULTANTS	SEA CONSULTANTS	QNT	AECON

URP Steel Reinforcement Specialist
(Thailand) Co., Ltd.

KINGDOM OF THAILAND
MINISTRY OF TRANSPORT
MASS RAPID TRANSIT AUTHORITY OF THAILAND